


<b>Community</b>	<b>Aulendorf</b>						
<b>Infrastructure</b>	<b>500 m</b>						
<b>Distances</b>	<b>3x2-50 HDPE</b>						
<b>Reinstatement</b>	SA 200 m						
<b>Depth</b>	-1,00	-1,00	-1,00	-1,00	-1,00	-1,00	-1,00
<b>Laying Type</b>	SA 500 m						

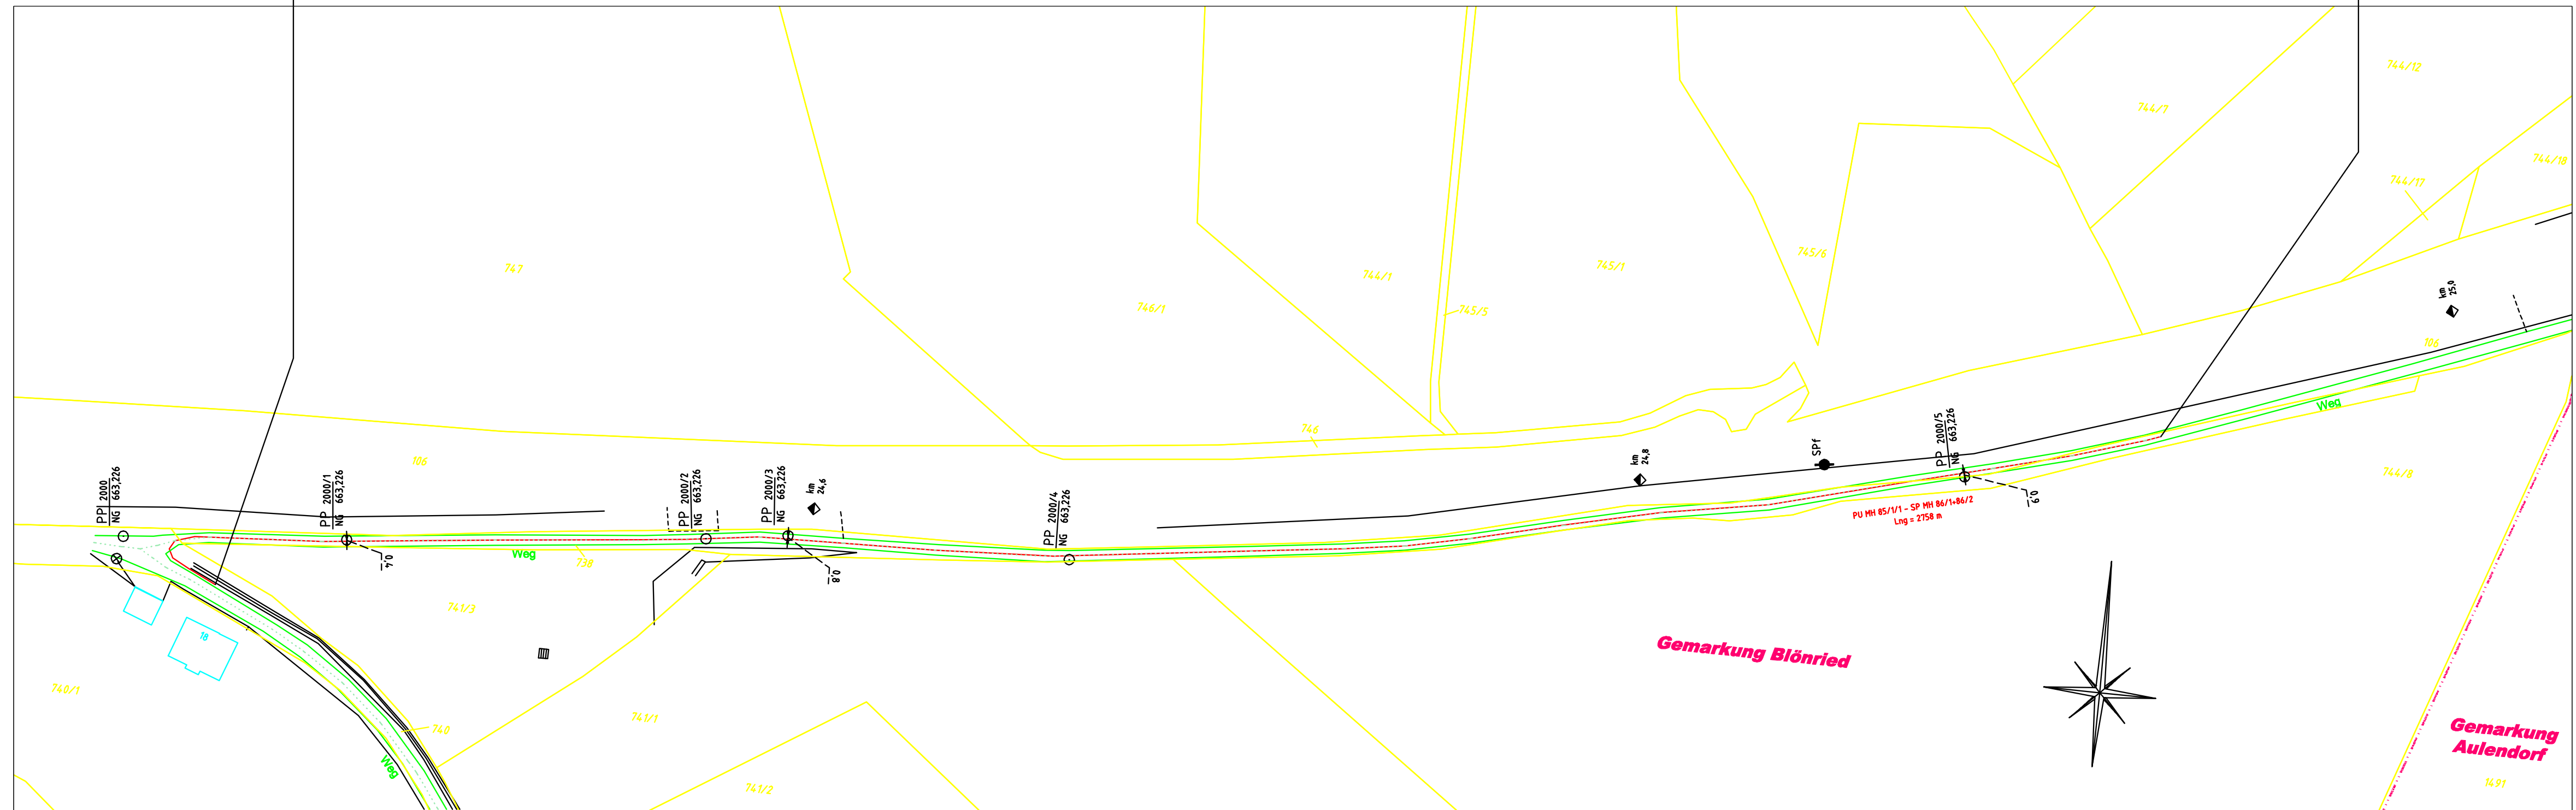

**Legende**

Bodenbeschaffenheit	
CO	Beton
SA	Sand

Wiederherstellung	
CO	Beton
SA	Sand
PV	Pflaster
AS	Bitumen

000 Detail Nummer

**abc**  
TELIA Viking  
Network

Bestandsplan  
Zürich - München  
CPV

Drawing Number:	DE_233_A	Revision:	A	Date:	11/2001	Prepared by:	N. Kurth	Approved by:		Remark:	Dokumentation
Scale:	1/1000	Sheet:	233								
File name:	DE_233_A.dwg										
Coordinate system:	Gaus Krueger										