


Community	Aulendorf						
Infrastructure	500 m						
Distances	3x2-50 HDPE						
Reinstatement							
Depth	-1.00	-1.00	-1.00	-1.00	-1.00	-1.00	-1.00
Laying Type							

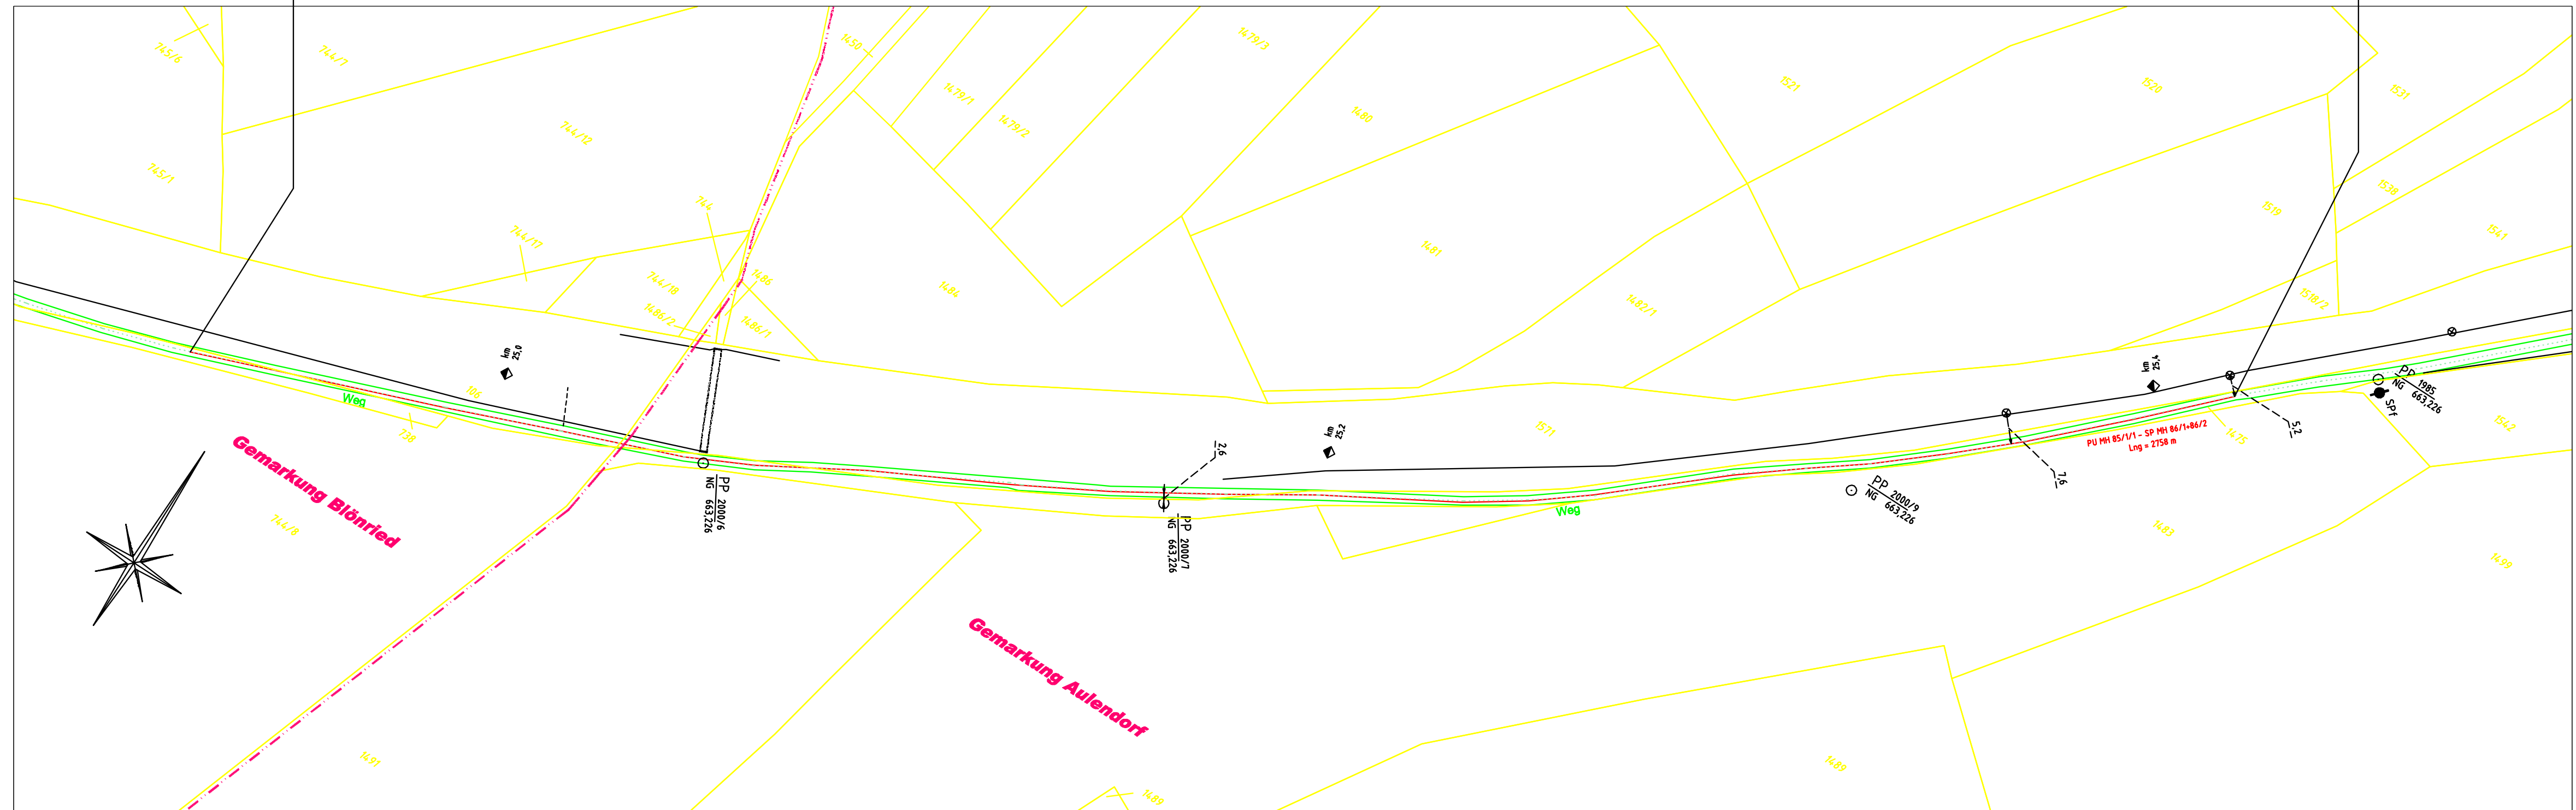

Legende

Bodenbeschaffenheit	
CO	Beton
SA	Sand
Wiederherstellung	
CO	Beton
SA	Sand
PV	Pflaster
AS	Bitumen

000 Detail Nummer

abc
TELIA Viking
Network

Bestandsplan
Zürich - München

Drawing Number:	DE_234_A	Revision:	A	Date:	11/2001	Prepared by:	N. Kurth	Approved by:		Remark:	Dokumentation
Scale:	1/1000	Sheet:	234								
File name:	DE_234_A.dwg										
Coordinate system:	Gaus Krueger										